

Northern Track

Purpose: All or most incoming construction traffic; no exiting traffic

Current use: Farm track, infrequent use; alternative to east-west bridleway for recreational use when common impassably wet

Description of construction in application documents: none

Construction issues: Streams culverted under track in several places, at times running alongside. South west corner of common exceptionally wet and marshy, existing culvert under track draining marsh E to stream W.

Southern track

Purpose: All exiting construction traffic and some incoming; all AILS

Current use: Byway Open to All Traffic and principle recreational route across common for walkers, cyclists and horse riders

Description of construction in application documents: none, except figures 1.2.2-1.2.4 in ES Vol II Figures

Construction issues: Undulating ground, substantial cut and fill; River Edw (feeder to Wye SAC) running through marshy ground just to south

Hendy Windfarm Ltd.

Nr Llandrindod Wells,
Powys


Redline Boundary and
Site Layout (Rev A)



Ownership boundary



Application area

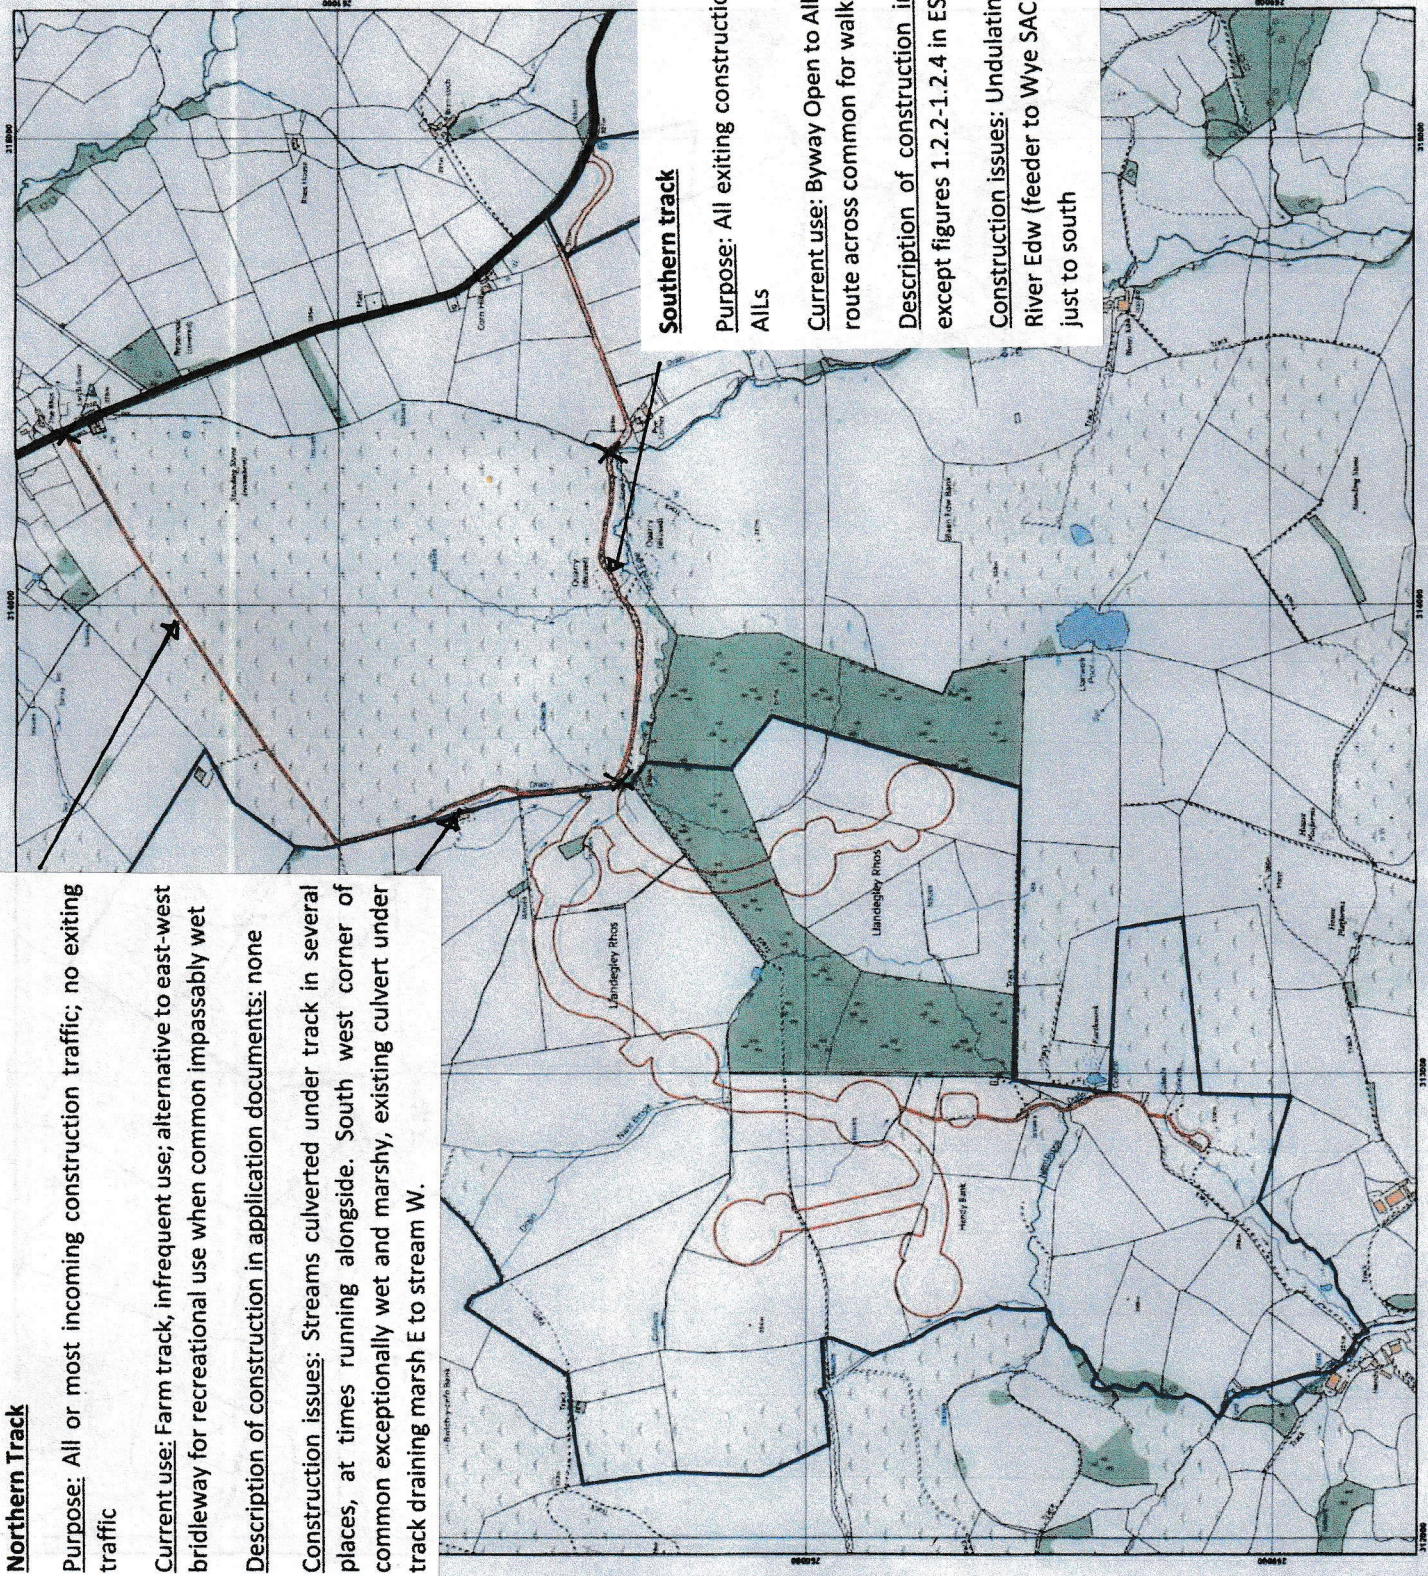

(Sept. 14)

Drawn by Paul Taylor 15/09/2014. Verified by Alan McLenon 15/09/2014



Scale 1:1000 at A3 size
This map is reproduced from Ordnance Survey material with the permission of Ordnance Survey on behalf of the Controller of Her Majesty's Stationary Office © Crown copyright. Unauthorised reproduction infringes Crown Copyright and may lead to prosecution or civil proceedings.
ADAS Licence no. AL10026003 September 2014



ADAS UK Ltd, Pentolow House,
Pentolow, Wotton Bassett, Wiltshire, W16 1TQ,
UK
Tel: +44(0)1602 271300 Fax: +44(0)1602 785574